F.A.R.A. REGION	STATE	PROJECT NO.	SHEET NO.	TOTAL SHEETS	AS BUILT
9	ARIZ.	179-A-(002)B	649	760	
		179 CN 310			

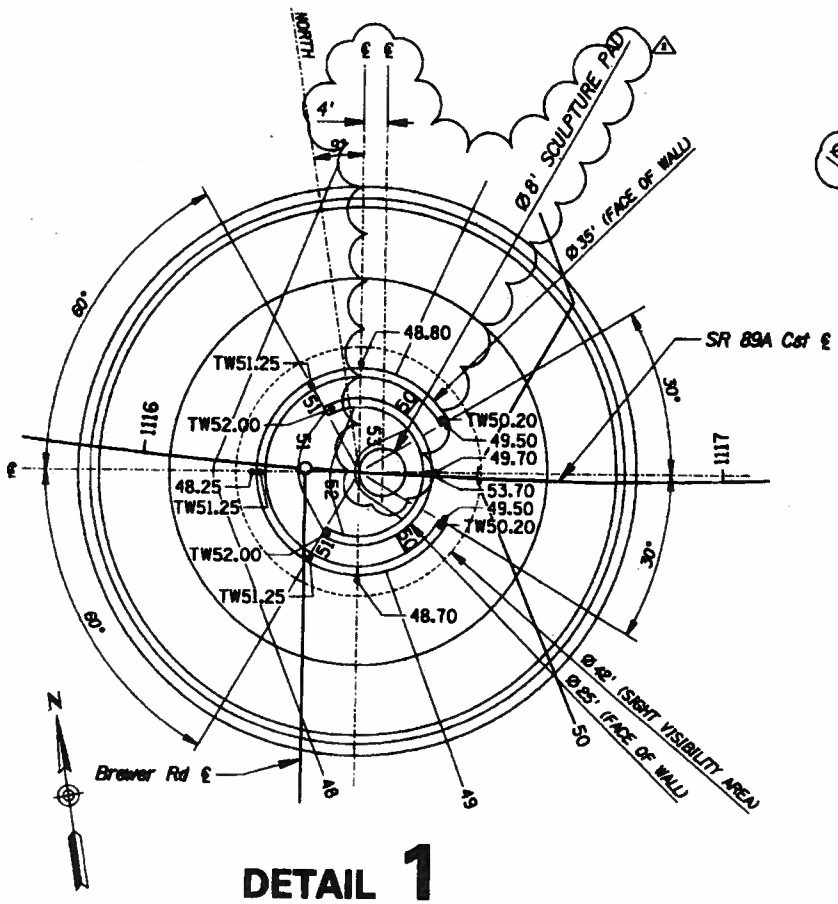

DETAIL 1

ROUNDABOUT @ SR89A AND BREWER ROAD

Scale: 1" = 10'-0"

NOTE:
SEE DETAIL 8, SHEET P-3.02
FOR WALL DETAIL.

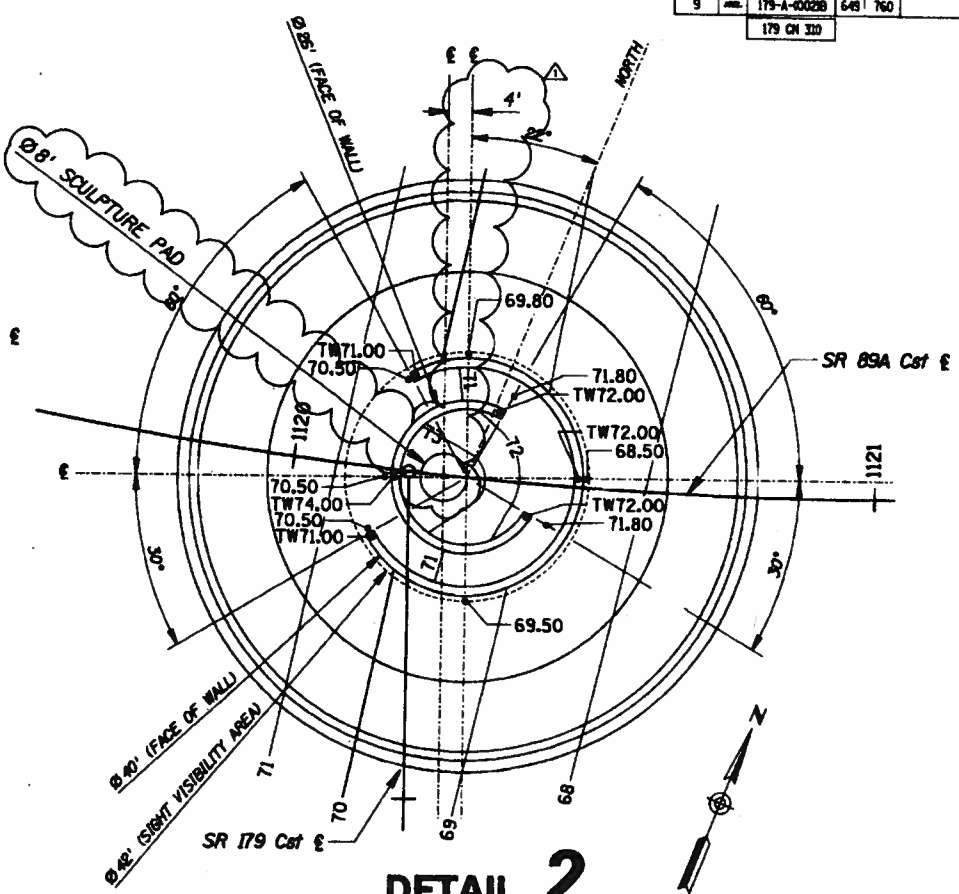

DETAIL 2

ROUNDABOUT @ SR179 AND SR89A

Scale: 1" = 10'-0"

SCALE: 1" = 10'

DESIGN	RING/BLG		ARIZONA DEPARTMENT OF TRANSPORTATION INTERNATIONAL TRANSPORTATION DIVISION ROADWAY DESIGN SERVICES
DRAWN	AMR		
CHECKED	RING/BLG		ROUNDABOUT LAYOUT AND FINISH GRADING PLANS
DIMM HARRIS	AECOM		
SHEET SR 179	LOCATION		VILLAGE OF OAK CREEK TO NORTH FOREST BOUNDARY
TRACS NO. H 3414 03C		179-A-(002)B	DWG. NO. P-3.01 OF